

NOTES:

- This plan sheet is a record drawing from Skyway Structures contract. The Contractor shall verify the existing installation. See sheet EE-66 of Skyway Structures, contract No. 04-012024.
- The installed components shall not be limited to the ones listed below, but shall be a complete installation. For details, see Bridge Structures Girder Westbound, typical Details sheets.
  - Furnish and install 15 kV cables into existing cable tray shown on this drawing. Refer to riser diagram on sheets E-664 and E-665.
  - Furnish and install TOS fiber optic cables into existing cable tray shown on this drawing. Refer to riser diagram on sheets E-978 through E-981.
  - Inspect for system ground continuity. See sheets E-666 and E-667.
- All cable trays shown on this drawing are existing. Bold ones are to be used for pulling cable.

SHEET NOTES:

- Furnish and install splice cable tray as shown on sheet E-663, plan detail 1.
- For Hinge BW area details, see sheet E-642.
- Furnish and install splice cable tray as shown on sheet E-663, plan detail 2.

REQUEST FOR INFORMATION NOT ADDRESSED IN THIS CCO REMAIN IN FORCE					
0	03/08/10	MEP INTEGRATION	SYC	FW	110
MARK	DATE	DESCRIPTIONS	BY	CH'D	CCO#
REVISIONS					


CONTRACT CHANGE ORDER NO. \_\_\_\_\_  
SHEET \_\_\_\_\_ OF \_\_\_\_\_

BRIDGE STRUCTURES GIRDER WESTBOUND

SKYWAY STRUCTURES

SCALE: 1:200

THIS PLAN ACCURATE FOR ELECTRICAL WORK ONLY.

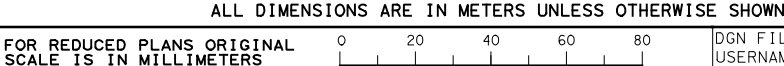

DGN FILE =>04-0120f1\_E-605.dgn  
USERNAME =>iloric

CU 04251

EA 0120F1

DIST	COUNTY	ROUTE	KILOMETER TOTAL PROJECT	POST PROJECT	SHEET No	TOTAL SHEETS
04	SF, Alameda	80	12.2/14.3 0.0/4.0	407a 06S06	1204	

Syn Yee Chin

03/08/10

REGISTERED ELECTRICAL ENGINEER

DATE

05-06-2010

PLANS APPROVAL DATE

PB AMERICAS, Inc.  
A Parsons Brinckerhoff Company  
303 Second St., Suite 700N  
San Francisco, CA 94107-1317

REGISTERED PROFESSIONAL ENGINEER

SYN YEE CHIN

No. 18186

Exp. 09/30/2011

ELECTRICAL

STATE OF CALIFORNIA

The State of California or its officers or agents shall not be responsible for the accuracy or completeness of electronic copies of this plan sheet.

Caltrans now has a web site. To get to the web site, go to <http://www.dot.ca.gov>